

### SFMTA - TASC SUMMARY SHEET

PreStaff_Date: 9/15/2020	Public Hearing	Consent	No objections:	
Requested_by: SFFD	Public Hearing I	Regular	Item Held:	
Handled: Jeffrey Tom 646-4315	Informational / 0	Other	Other:	
Section Head : BBD	PH - Regular			
Location: Rodgers Street at Folsom Street				
Subject: Tow-Away No Stopping Fire Lane				
PROPOSAL / REQUEST: RESCIND - 2 HOUR PARKING, 8 AM THROUGH 10 PM, EVERYDAY, EXCEPT VEHICLES WITH AREA U PERMITS ESTABLISH - TOW-AWAY NO STOPPING FIRE LANE Rodgers Street, east side, from 195 to 275 feet south of Folsom Street (eliminates 4 parking spaces) (Supervisor District 6)  Proposal to establish a fire lane at the request of the Fire Department for the 349 8th Street project.  Jeffrey Tom, jeffrey.tom@sfmta.com				
BACKGROUND INFORMATION / COMMENTS  Rodgers Street is an alley with an 18-ft wide roadway. Parking is prohibited on the west side, with RPP parking on the east side. No sidewalk widening is proposed.				
HEARING NOTIFICATION AND PRO		☐ SFM1	IMENTAL CLEARANCE BY:  Attached Pending	

Proposed Tow-Away No Stopping Fire Lane – Rodgers Street, east side, from 195 to 275 south of Folsom Street

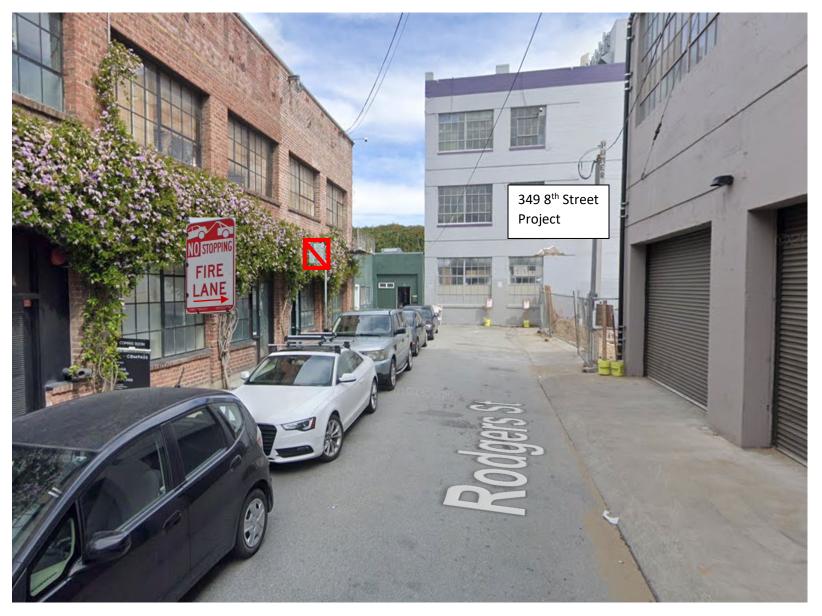

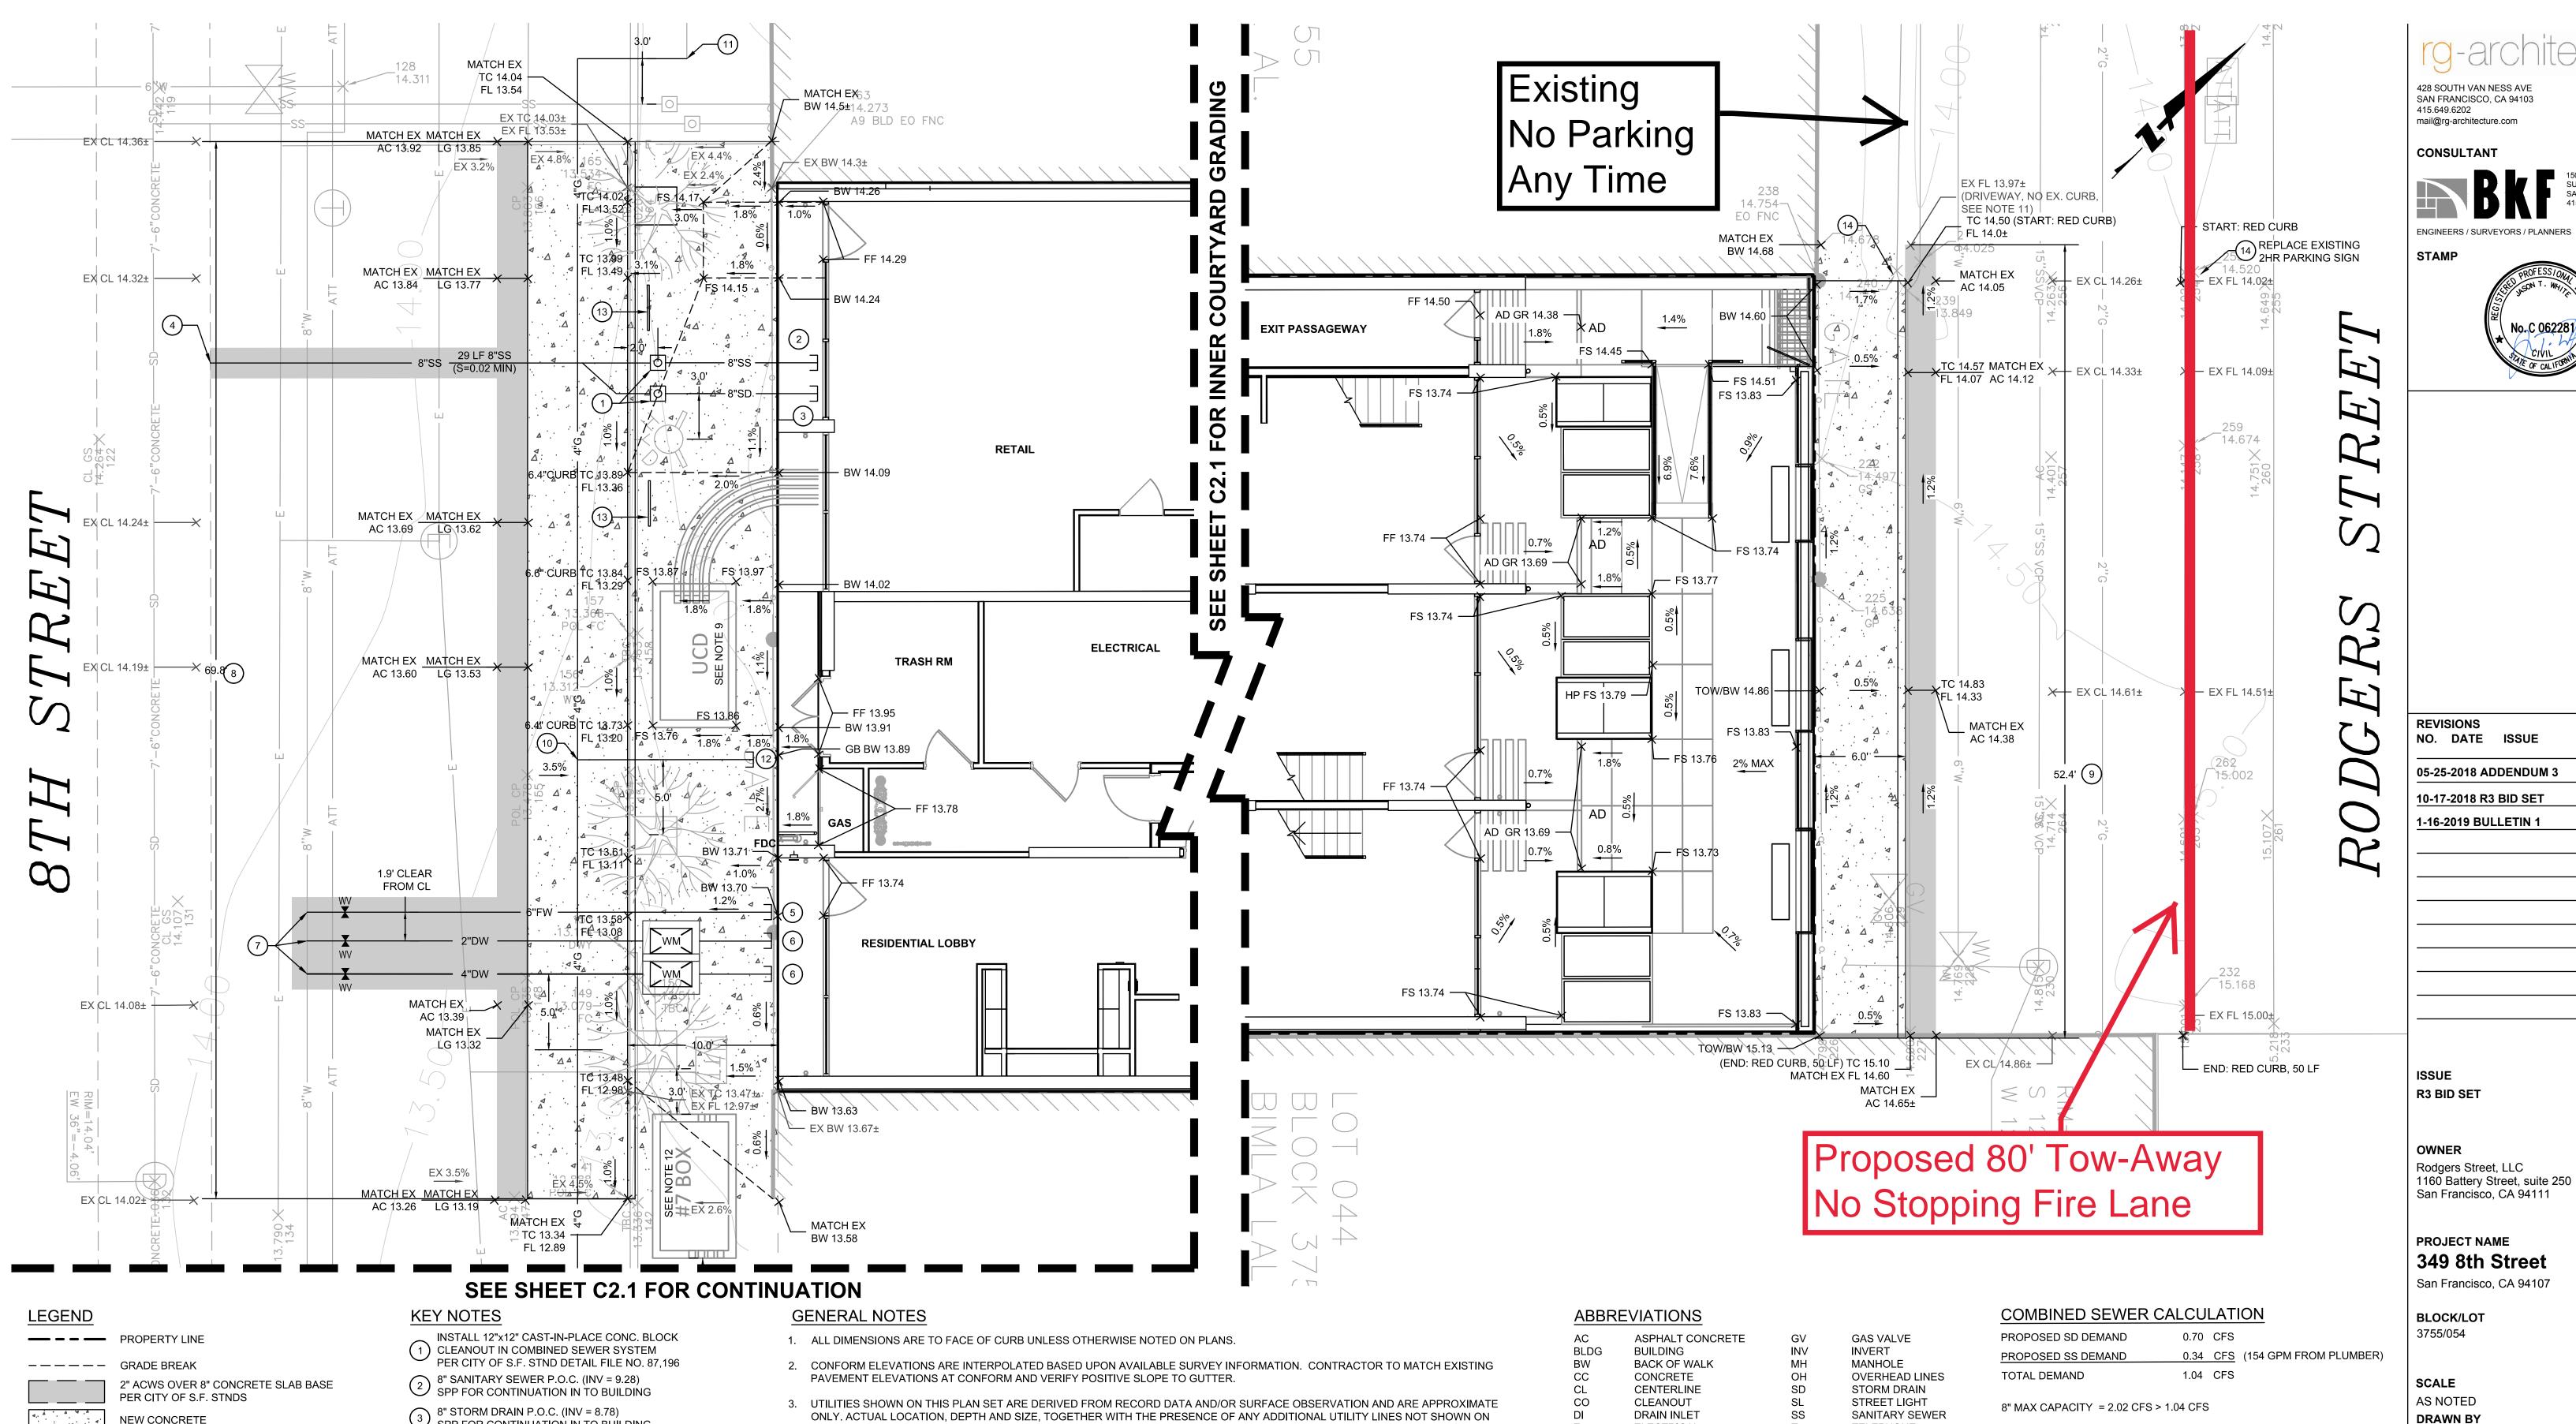

**NEW CONCRETE** 

——SS—— SANITARY SEWER LINE

— STORM DRAIN LINE

— DOMESTIC WATER LINE

FIRE WATER LINE

— ELECTRICAL LINE

——ATT—— TELECOMMUNICATION LINE

——COM——— COMCAST LINE

WATER VALVE

STORM DRAIN CLEANOUT

WATER METER

EXISTING ELEVATIONS (SEE NOTE 10)

PROPOSED ELEVATIONS (SEE NOTE 10)

- 8" STORM DRAIN P.O.C. (INV = 8.78) SPP FOR CONTINUATION IN TO BUILDING
- $\begin{array}{c}
  \text{SEWER CONNECTION} \\
  \text{TO MAIN (SEE NOTE 6)} \\
  \end{array}
  \begin{array}{c}
  9 \\
  \text{C4.0}
  \end{array}$
- 6" FIRE WATER P.O.C.

  SPP FOR CONTINUATION IN TO BUILDING
- 6 DOMESTIC WATER P.O.C. SPP FOR CONTINUATION IN TO BUILDING
- WATER LINE CONNECTION TO 8" MAIN PER SFWD DETAIL A-1240-2A OR A-1240-2B
- 8 STANDARD COMBINED CURB AND PARKING STRIP PER CITY OF S.F. STND DETAIL FILE 87,170
- 9 STANDARD CONCRETE CURB PER CITY OF S.F. STND DETAIL FILE 87,169
- (10) GAS LINE CONNECTION TO RELOCATED MAIN
- RELOCATED GAS LINE CONNECTION TO EXISTING 4" GAS LINE, WORK TO BE PERFORMED BY PG&E
- GAS P.O.C. SPP FOR CONTINUATION INTO BUILDING
- (13) CLASS 2 BICYCLE PARKING INSTALL DOUBLE SIDED "NO PARKING ANYTIME (DOUBLE ARROW) SIGN

- ONLY. ACTUAL LOCATION, DEPTH AND SIZE, TOGETHER WITH THE PRESENCE OF ANY ADDITIONAL UTILITY LINES NOT SHOWN ON THIS PLAN SHALL BE VERIFIED IN THE FIELD PRIOR TO CONSTRUCTION.
- 4. PRIOR TO DIGGING, CALL 811 AT LEAST 48 HOURS IN ADVANCE TO HAVE EXISTING UNDERGROUND UTILITIES MARKED.
- 5. GRADING OPERATIONS WILL OCCUR OVER EXISTING UTILITIES. CONTRACTOR SHALL EXERCISE THE NECESSARY CARE IN THESE AREAS TO ENSURE EXISTING UTILITIES ARE NOT DAMAGED OR EXPERIENCE ANY INTERRUPTION IN SERVICE. ANY UTILITIES DAMAGED DUE TO CONTRACTOR'S ACTIVITIES SHALL BE REPAIRED TO ORIGINAL CONDITION AT THE EXPENSE OF THE CONTRACTOR.
- 6. CONTRACTOR TO FIELD VERIFY SANITARY SEWER MAIN INVERT AND PIPE MATERIAL PRIOR TO CONSTRUCTION. PROPOSED LATERAL TO MAINTAIN A MINIMUM SLOPE OF 2.0% FROM BUILDING POINT OF CONNECTION TO TRUNK LINE. CITY OF SAN FRANCISCO STANDARD TRUNK CONNECTIONS TO BE USED FOR LATERAL CONNECTION TO SPRING LINE OF MAIN. NOTIFY ENGINEER OF ANY DISCREPANCIES.
- 7. CONTRACTOR TO POTHOLE AND FIELD VERIFY ALL UTILITY CROSSINGS.
- 8. UTILITY BOXES SHALL BE REINFORCED PER CITY STANDARD SIDEWALK AS DEFINED IN SECTION 204 OF THE DEPARTMENT OF PUBLIC WORKS STANDARD SPECIFICATIONS.
- 9. UCD IS SHOWN FOR REFERENCE ONLY, DESIGN DONE BY OTHERS.
- 10. WHEREVER PROPOSED GRADES STATE "MATCH EX", APPROXIMATE EXISTING GRADE IN THIS LOCATION IS TO BE HELD AS CONFORM POINT. ALL EXISTING ELEVATIONS SHOWN WITHIN THE LIMIT OF WORK ARE FOR REFERENCE TO CHANGES IN GRADE OF PROPOSED GRADES ONLY, NOT FOR FUTURE GRADING PURPOSES.
- 11. THERE IS NO EXISTING CURB ALONG RODGERS STREET WITHIN OUR LIMIT OF WORK. ENTIRE STRETCH IN FRONT OF PROPERTY IS A DRIVEWAY CURB CUT.

BBK	EVIATIONS		
2	ASPHALT CONCRETE	GV	GAS VALVE
.DG	BUILDING	INV	INVERT
٧	BACK OF WALK	MH	MANHOLE
2	CONCRETE	ОН	OVERHEAD LINES
_	CENTERLINE	SD	STORM DRAIN
)	CLEANOUT	SL	STREET LIGHT
	DRAIN INLET	SS	SANITARY SEWE
	ELECTRICAL	Т	TELEPHONE
_	ELEVATION	TC	TOP OF CURB
3	EXISTING SURFACE	TOW	TOP OF WALL
	FLOWLINE	TYP	TYPICAL

FINISHED SURFACE

**GRADE BREAK** 

GRADE

WATER

WATER METER

WATER VALVE

- RATIONAL EQUATION USED TO CALCULATE PROPOSED STORM DRAIN
- DEMAND (Q = CiA).
- MANNINGS EQUATION USED TO CALCULATE
- VELOCITY OF 8" COMBINED SEWER PIPE AT 2.0% SLOPE. ASSUMED PIPE FLOW FULL
- ASSUMED SMOOTH INTERIOR WALLS

GRAPHIC SCALE: 1" = 5"



## **GRADING AND UTILITY PLAN**

M. THOMAS

J. WHITE

20165004

DATE

8/19/20


**CHECKED BY** 

PROJECT NO.

DRAWING NO. 2 of 07


Call before you dig

SHEET 1 OF 2

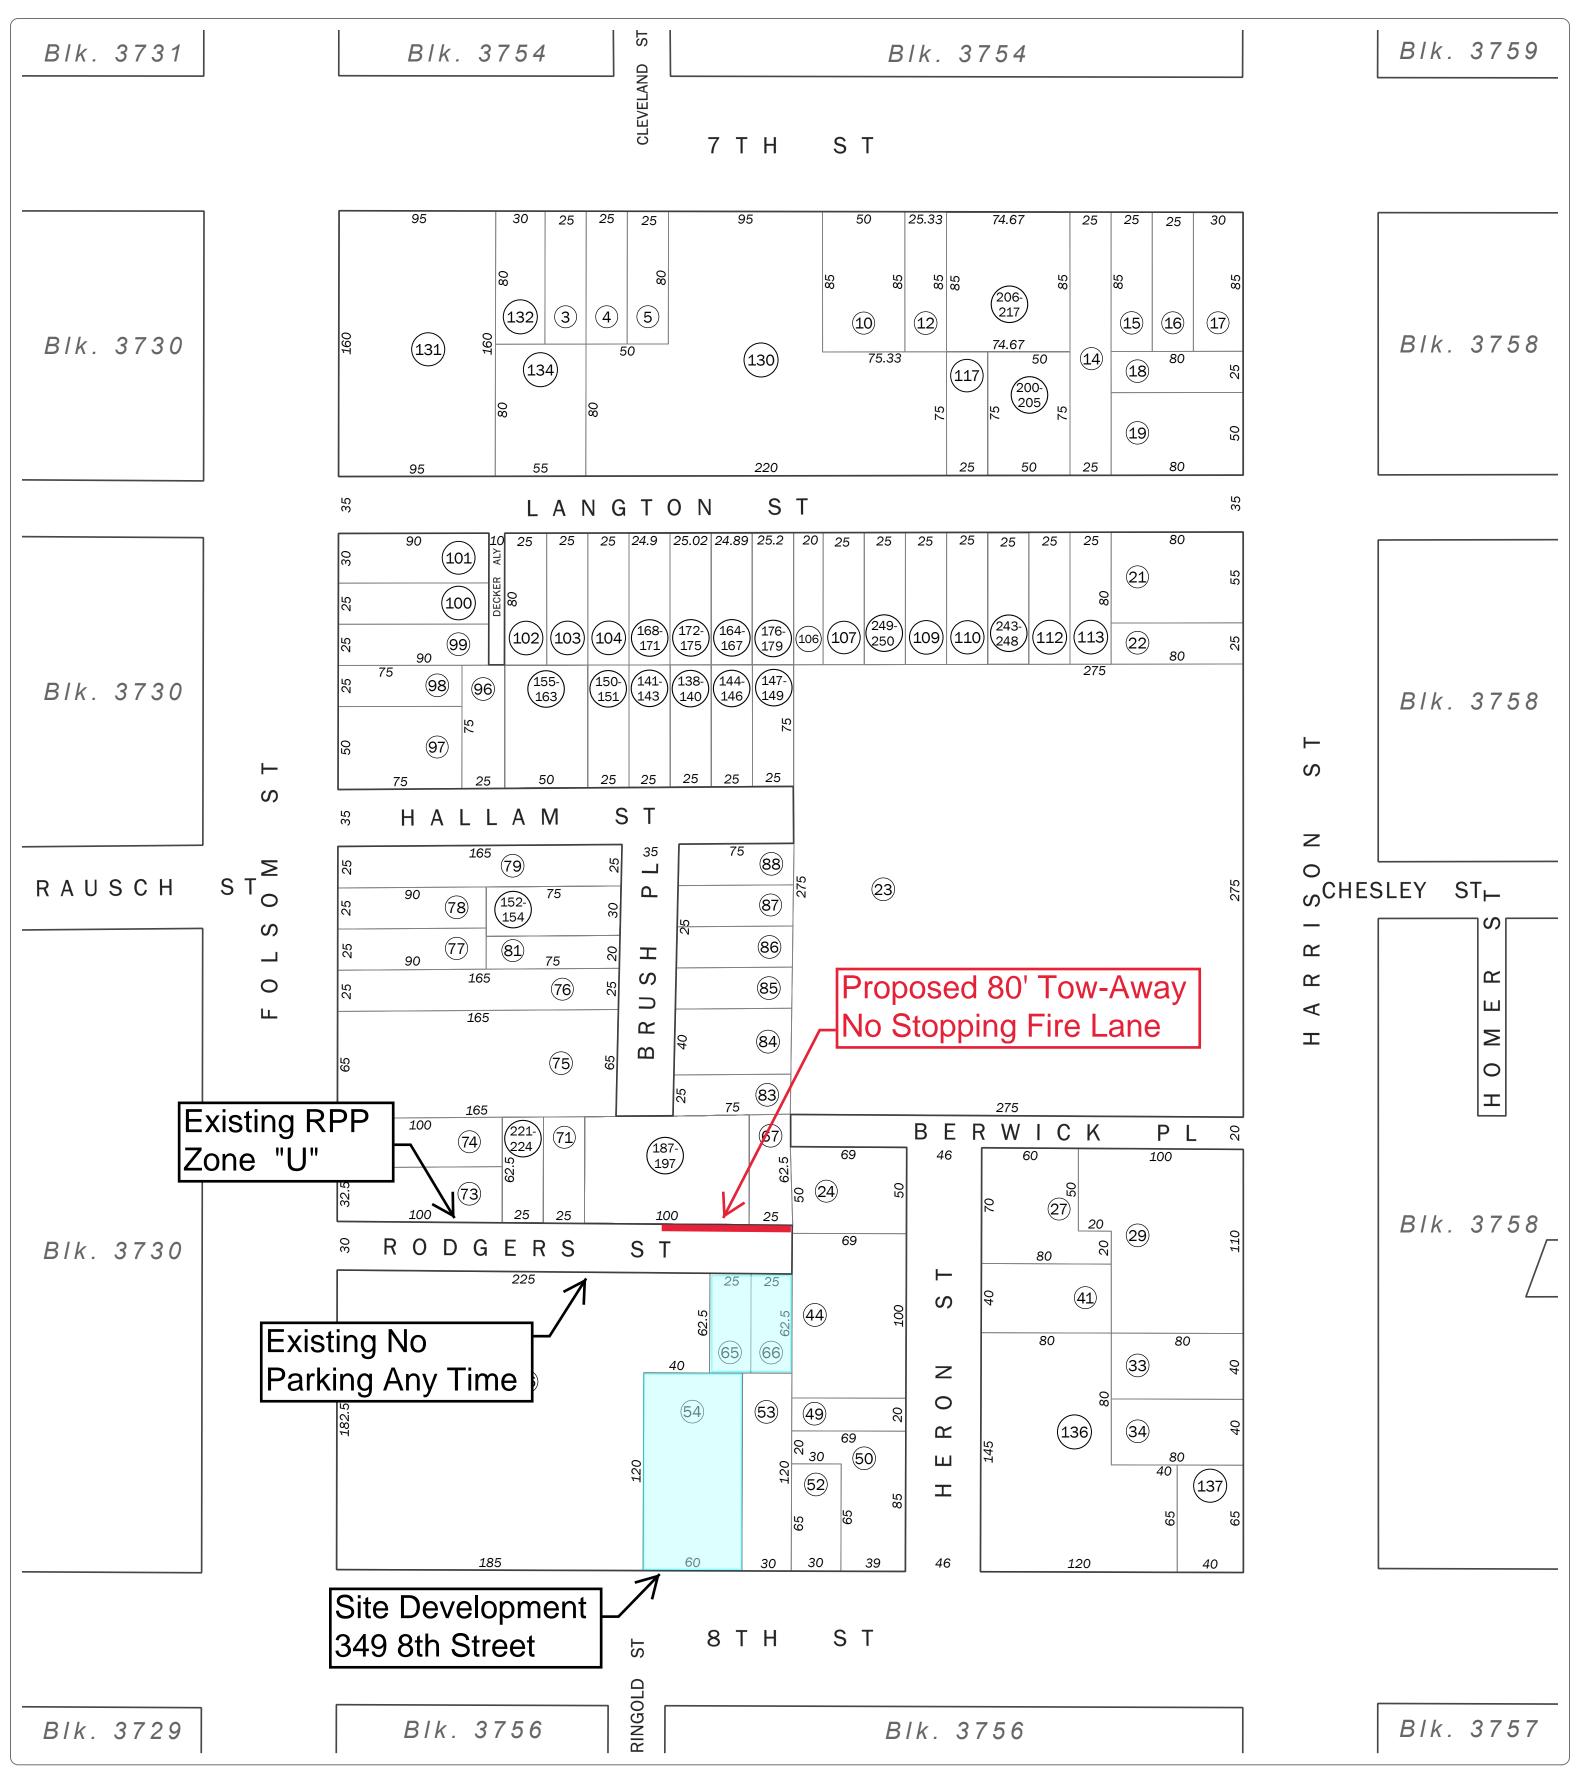

# SAN FRANCISCO CITY & COUNTY ASSESSOR'S BLOCK MAP

DISCLAIMER: THIS MAP WAS PREPARED FOR ASSESSMENT PURPOSES ONLY. ASSESSOR'S PARCELS MAY NOT COMPLY WITH LOCAL LOT-SPLIT OR BUILDING SITE ORDINANCES.

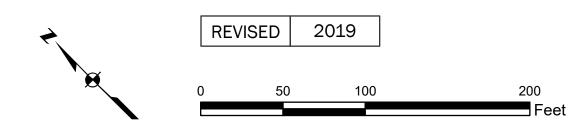

#### Tom, Jeffrey

From: Law, Chad (FIR)

**Sent:** Friday, August 14, 2020 3:54 PM

To: Wong, Norman

**Cc:** Wong, Jason (DPW); VerHagen, Adrian (DPW)

Subject: RE: PID 9902 - 349 8th Street

Hi Norman,

I just confirmed with Fire Marshal DeCossio that 80 ft or no parking with red curbs and signs would satisfy the Fire Department's Fire Access needs for the new building.

Thank you,

### Chad

#### Captain Chad Law

San Francisco Fire Department Bureau of Fire Prevention & Investigation 698 Second Street, Room 109 San Francisco, CA 94107 415-558-3300 (Main) 415-558-3306 (Direct) 415-558-3323 (Fax)

415-238-5319 (Cell)

#### chad.law@sfgov.org



CONFIDENTIALITY NOTICE: This communication and its contents may contain confidential and/or legally privileged information. It is solely for the use of the intended recipient(s). Unauthorized interception, review, use or disclosure is prohibited and may violate applicable laws, including the Electronic Communications Privacy Act. If you are not the intended recipient, please contact the sender and destroy all copies of the communication.

From: Wong, Norman < Norman. Wong@sfmta.com>

**Sent:** Wednesday, August 12, 2020 9:31 AM **To:** Law, Chad (FIR) <chad.law@sfgov.org>

Cc: Wong, Jason (DPW) <jason.c.wong1@sfdpw.org>; VerHagen, Adrian (DPW) <Adrian.VerHagen@sfdpw.org>

Subject: RE: PID 9902 - 349 8th Street

Hi Chad – after I sent my email, I saw this other attached email that you were not copied on which indicates the direction to mark the fire lane with hatched striping and pavement text.

#### Norman

From: Wong, Norman

**Sent:** Wednesday, August 12, 2020 9:16 AM **To:** Law, Chad (FIR) < <u>chad.law@sfgov.org</u>>

Cc: Wong, Jason (DPW) < <u>jason.c.wong1@sfdpw.org</u>>; VerHagen, Adrian (DPW) < <u>Adrian.VerHagen@sfdpw.org</u>>

Subject: RE: PID 9902 - 349 8th Street

Hi Chad – Per emails from the applicant, she mentioned she had been in contact with Chief DeCossio so I think they are aware of what SFFD wants but I will forward your attached comments anyway (and copy you).

I want to make sure I am clear on the Fire comments, specifically Comment #2 below about providing 80 ft turnaround for Rodgers dead-end. As you can see in the Google Streetview photo below, residential permit parking goes all the way to the end. So if SFMTA legislates 80 ft of "No Parking Anytime" and installs these signs or paints the adjacent curb red, does that satisfy Fire's requirement?

#### Thanks Norman

- 2. Rodgers Street dead-end is longer than 150 feet, as measured from the throat of the intersection. Please provide with a sufficient turnaround to the satisfaction of the SFFD.
- The SFFD has determined an 80-foot turnaround and a 40-foot radius to be sufficient.
- Please provide 80-foot turnaround for Rodgers Street dead-end.

